
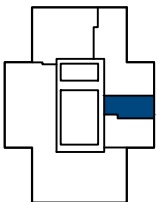


EXCHANGE TOWER

130 King Street West, Toronto, Ontario

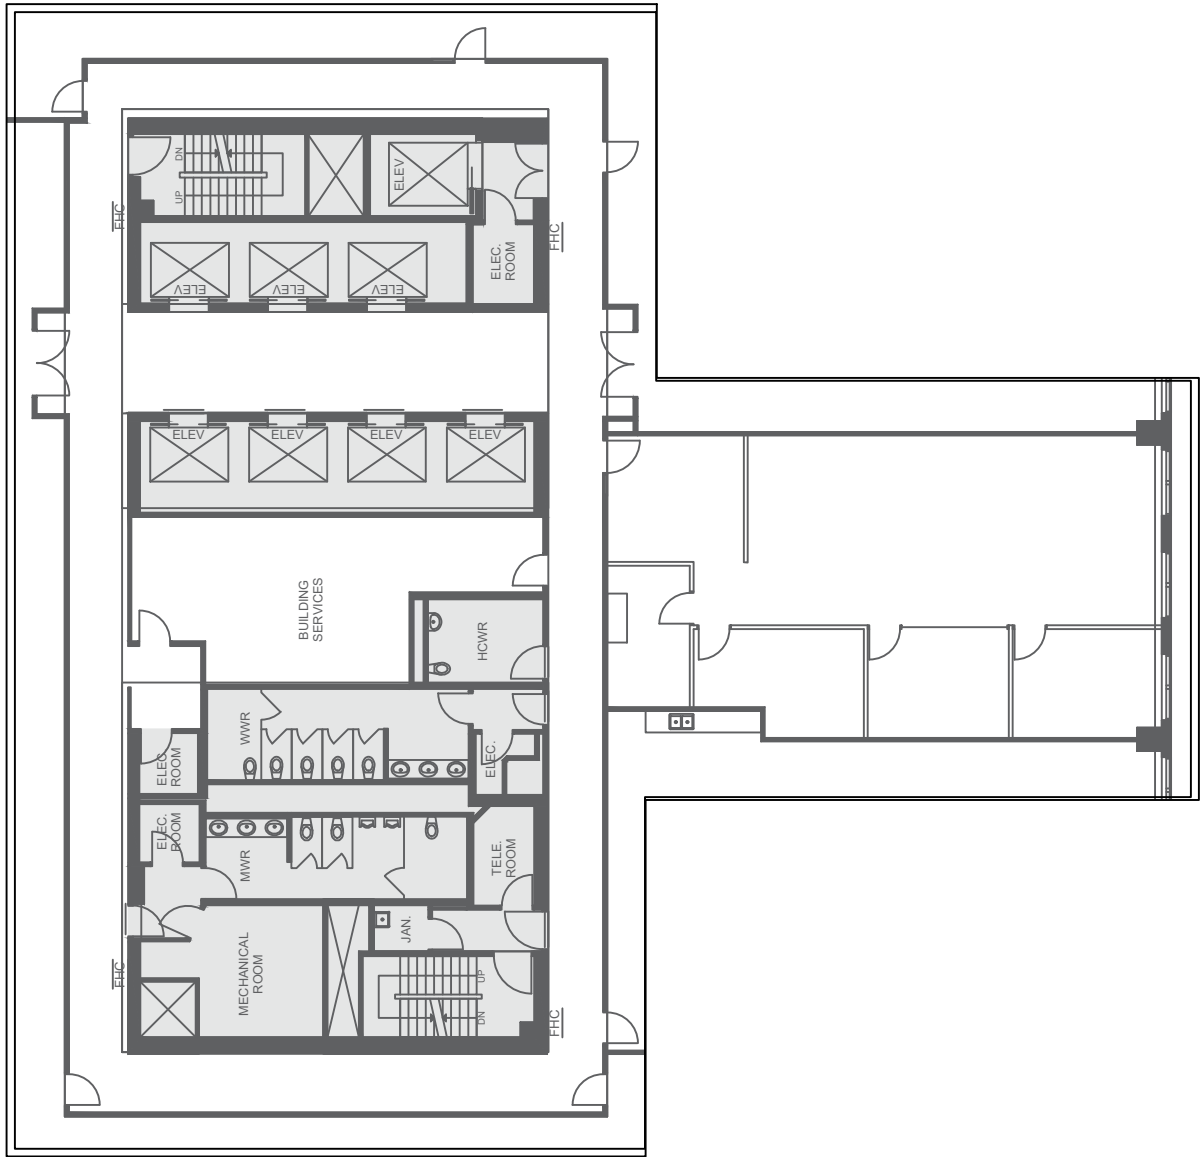

28th Floor

1,893 sf rentable square feet